


THT-19-435-1				
PART ID	MANUFACTURER	PART NUMBER	TORQUE (LB-IN)	WIRE TEMP (DEG C)
TB1	AB	1492-JSTCK	3.5-5.3	60
TB1-TB3	AB	1492-J3	3.7-7.1	60
GND BAR	NSI	4-14(12112)	45 (4-6 GA)	60
GND BAR	NSI	4-14(12112)	40 (8 GA)	60
GND BAR	NSI	4-14(12112)	35 (10-14 GA)	60
ISB5340	P+F	KFD2-SR2-Ex2.W	4.4	60
ISB5430	P+F	KFD2-SR2-Ex2.W	4.4	60

THT-19435-1				
Fuse ID	Manufacturer	Fuse# or Equivalent	Volts	
FU2010	BUSSMANN	MDL-5	250	
FU2400	BUSSMANN	MDL-2	250	
FU4340	BUSSMANN	MDL-2	250	
FU4520	BUSSMANN	MDL-2	250	
FU5010	BUSSMANN	MDL-2	250	
FU5060	BUSSMANN	MDL-2	250	
FU5100	BUSSMANN	MDL-2	250	
FU5120	BUSSMANN	MDL-2	250	
FU5140	BUSSMANN	MDL-2	250	
FU5160	BUSSMANN	MDL-2	250	

THT-19435-1				
Fuse ID	Manufacturer	Fuse# or Equivalent	Volts	
FU5180	BUSSMANN	MDL-2	250	
FU5200	BUSSMANN	MDL-2	250	
FU5220	BUSSMANN	MDL-2	250	
FU5240	BUSSMANN	MDL-2	250	
FU5260	BUSSMANN	MDL-2	250	
FU5280	BUSSMANN	MDL-2	250	
FU5220	BUSSMANN	MDL-2	250	
FU5030	BUSSMANN	MDL-2	250	

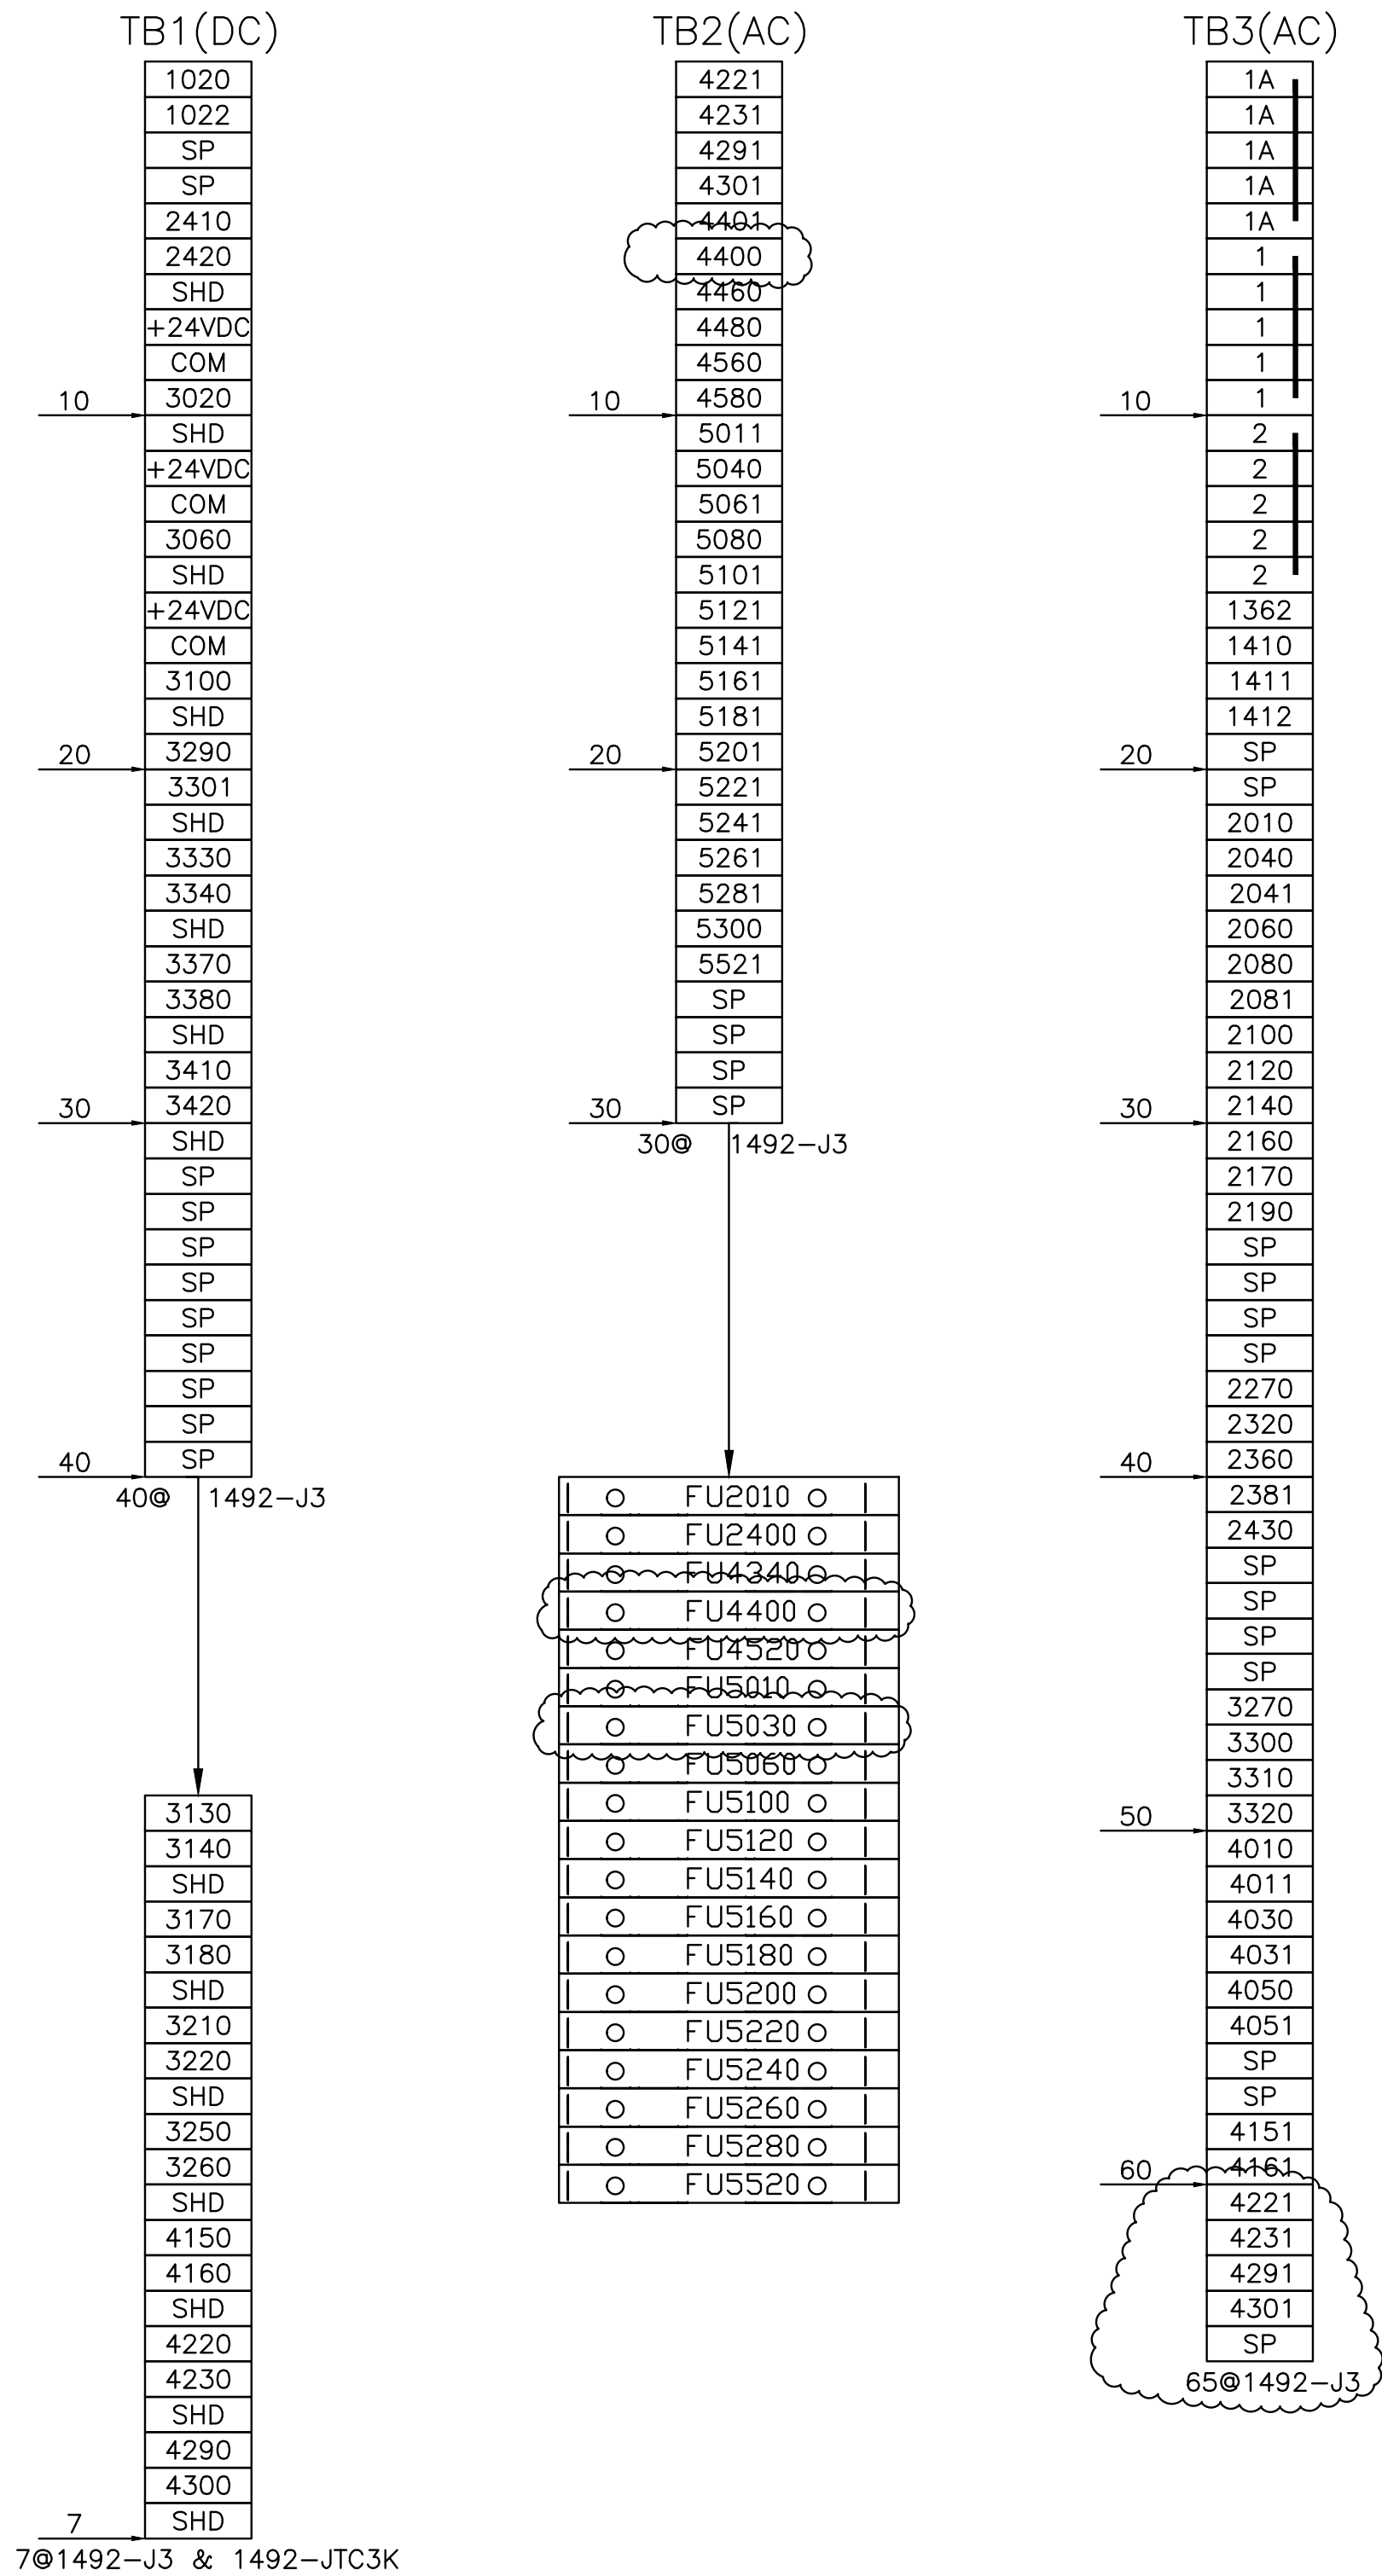

ANGUIL ENVIRONMENTAL SYSTEMS, INC. MILWAUKEE, WISCONSIN		REV. A	CUSTOMER SHAW ENVIRONMENTAL
TITLE MODEL 20 CATALYTIC OXIDIZER MAIN CONTROL PANEL SUB PANEL LAYOUT		DRAWING NO. 16512454	KIRTLAND AFB, NM
PAGE 5		OF 9	NOTE:
CHECKED: DATE:	APPROVED: DATE:	LAST CHANGED BY: DATE:	

A	RLG	9/18/12	AS BUILT
REV	BY	DATE	CHANGE

DRAWN RLG	DATE 8/19/12	AUTOCAD PATH JOBS\16000s\16512\ELEC
--------------	-----------------	--

SCALE NONE
